


ZZZ-MA-9002 MULTIPHASE FLOW METER

TYPE : GAMMA TYPE (NUCLEONIC)
METER SIZE : 4"
MPFM SKID SIZE : 6"
CAPACITY : GAS = 10 MMSCFD, OIL = 1500 BPD, WATER = 7840 BWPD
DESIGN CONDITION : 2000 psig @ 250°F
MOC : DUPLEX STEEL UNS S31803/A276
OPERATING PRESSURE : 250-450 psig
OPERATING TEMP : 170-210°F

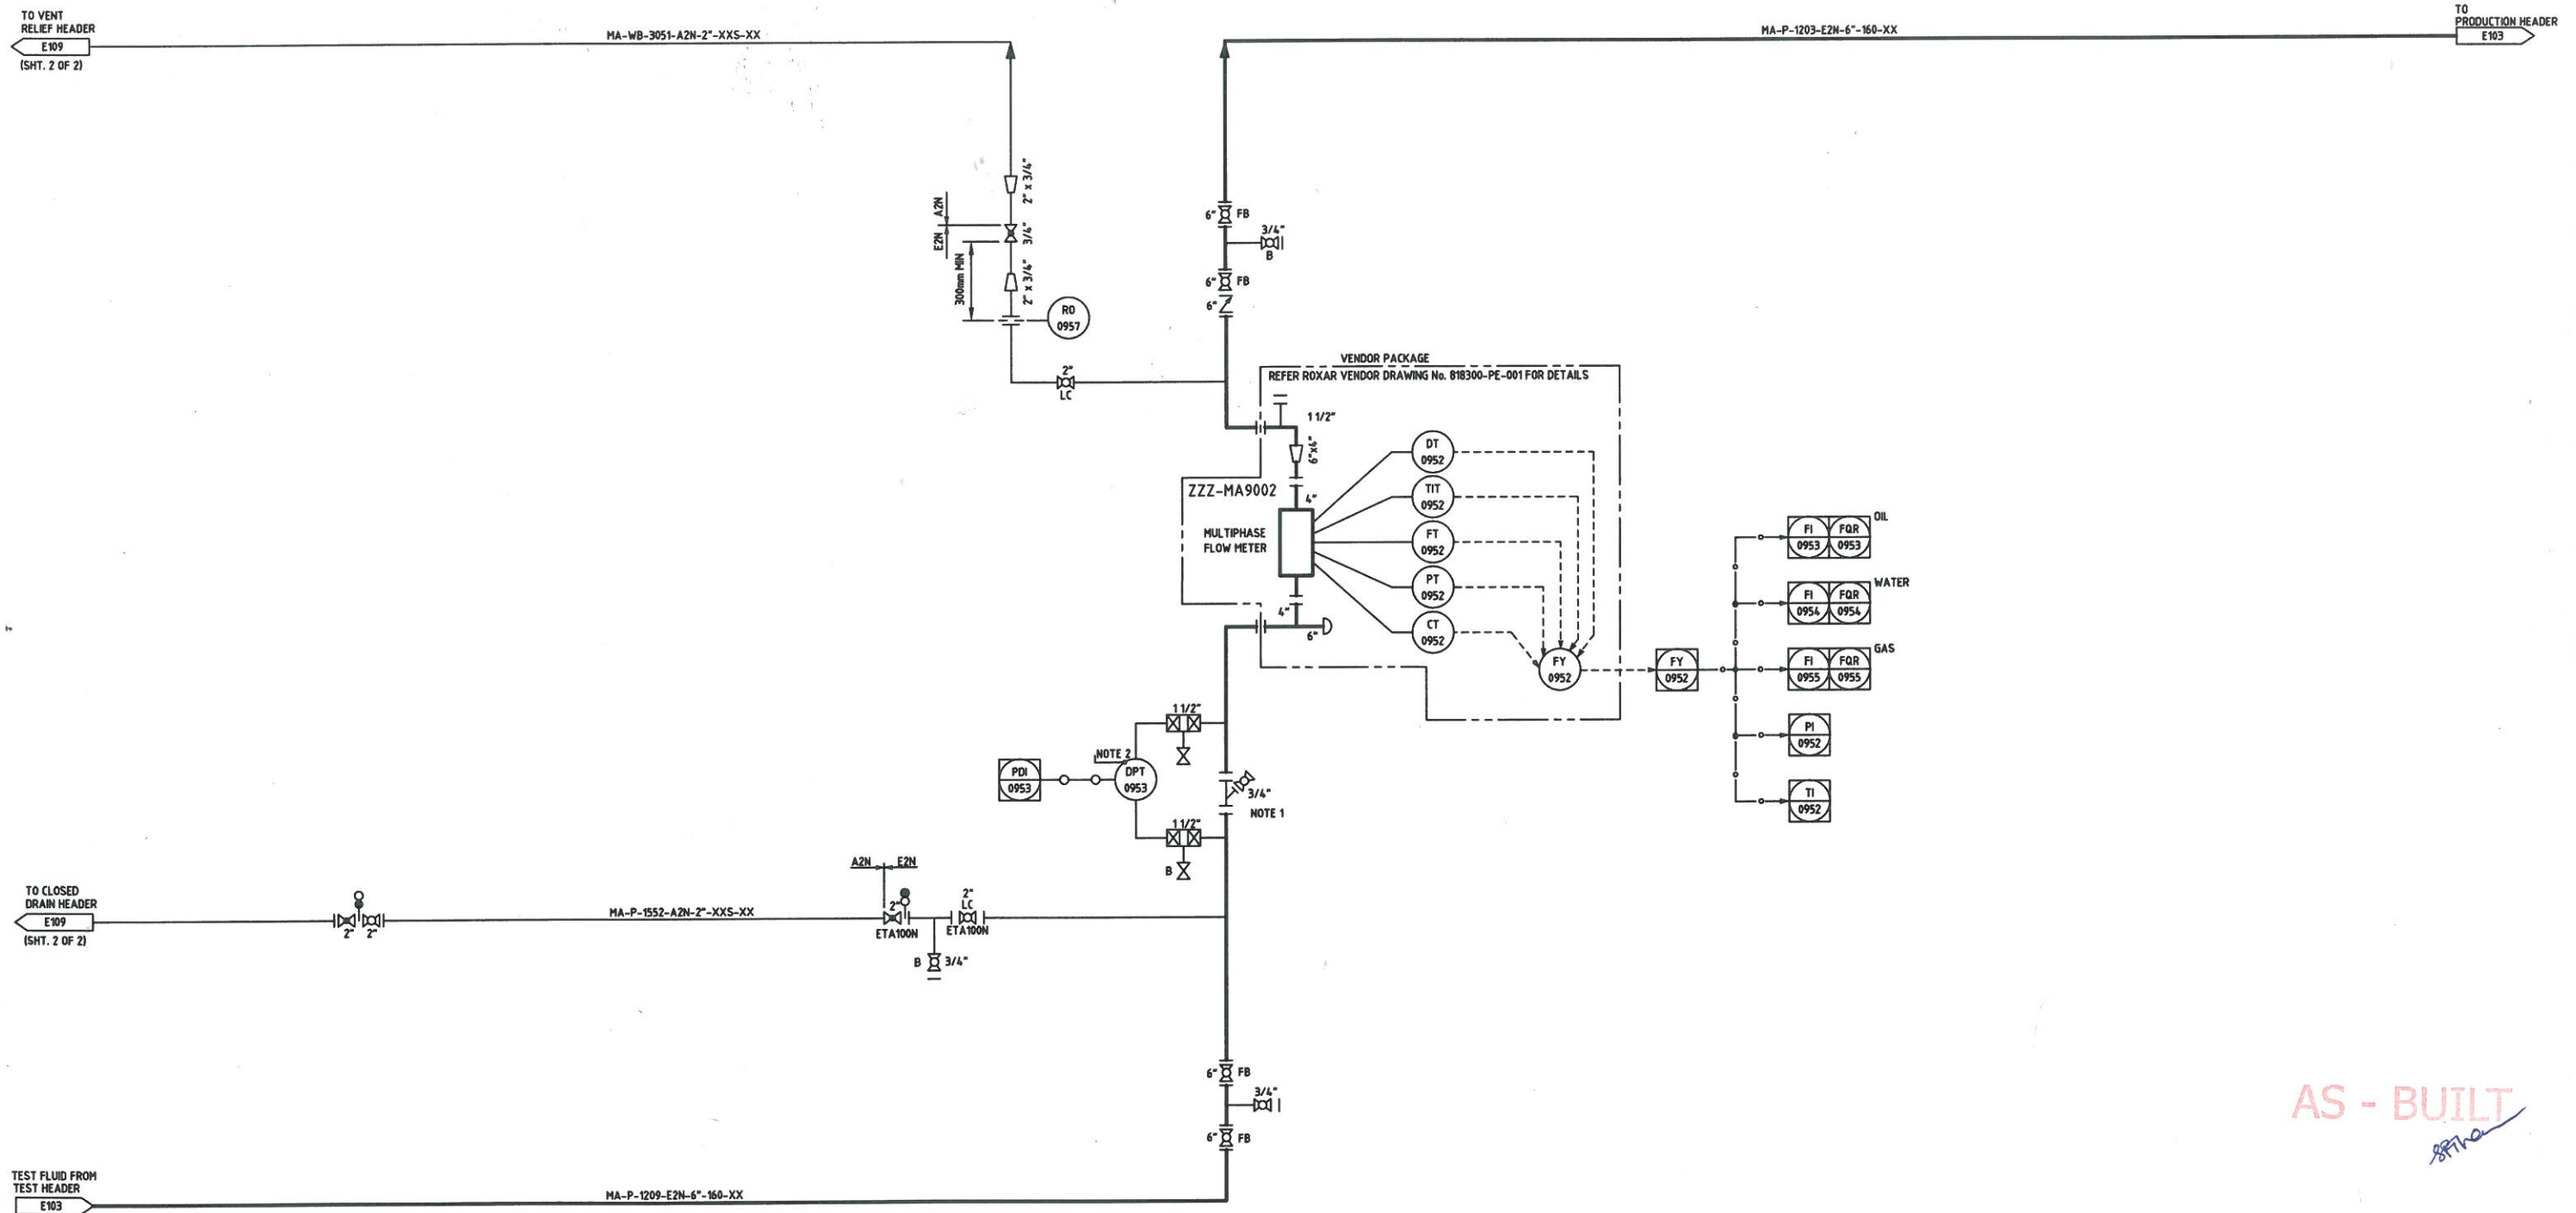

AS - BUILT
8/1/12

NOTES

- 1) STRAINER OF 200 MESH SIZE PROVIDED.
- 2) VIA WIRELESS GATEWAY.

NO.	DATE	REVISION	DRAWN	CHECKED	ENG.	PROJECT	ENG.
X2	29/12/16	UPDATED POST ESD MIGRATION AND HS PROJECT AS ON JAN 2016	RM	NH	SRT	SRT	
X1	01/06/12	AS BUILT AS ON MAY 2011	GD	ZS	SRT	SG	

<p>BG INDIA</p> <p>BG EXPLORATION AND PRODUCTION INDIA LIMITED</p>		CLIENT CONTRACT No.
--	--	---------------------

<p>MA PLATFORM MULTIPHASE FLOWMETER PIPING & INSTRUMENTATION DIAGRAM</p>		ORG. DRG. NO.
SCALE	NTS	DRG. NO.
<p>BGEP-BGPM-PXXX-MAXX-PR-11-000-E108</p>		REV. X2